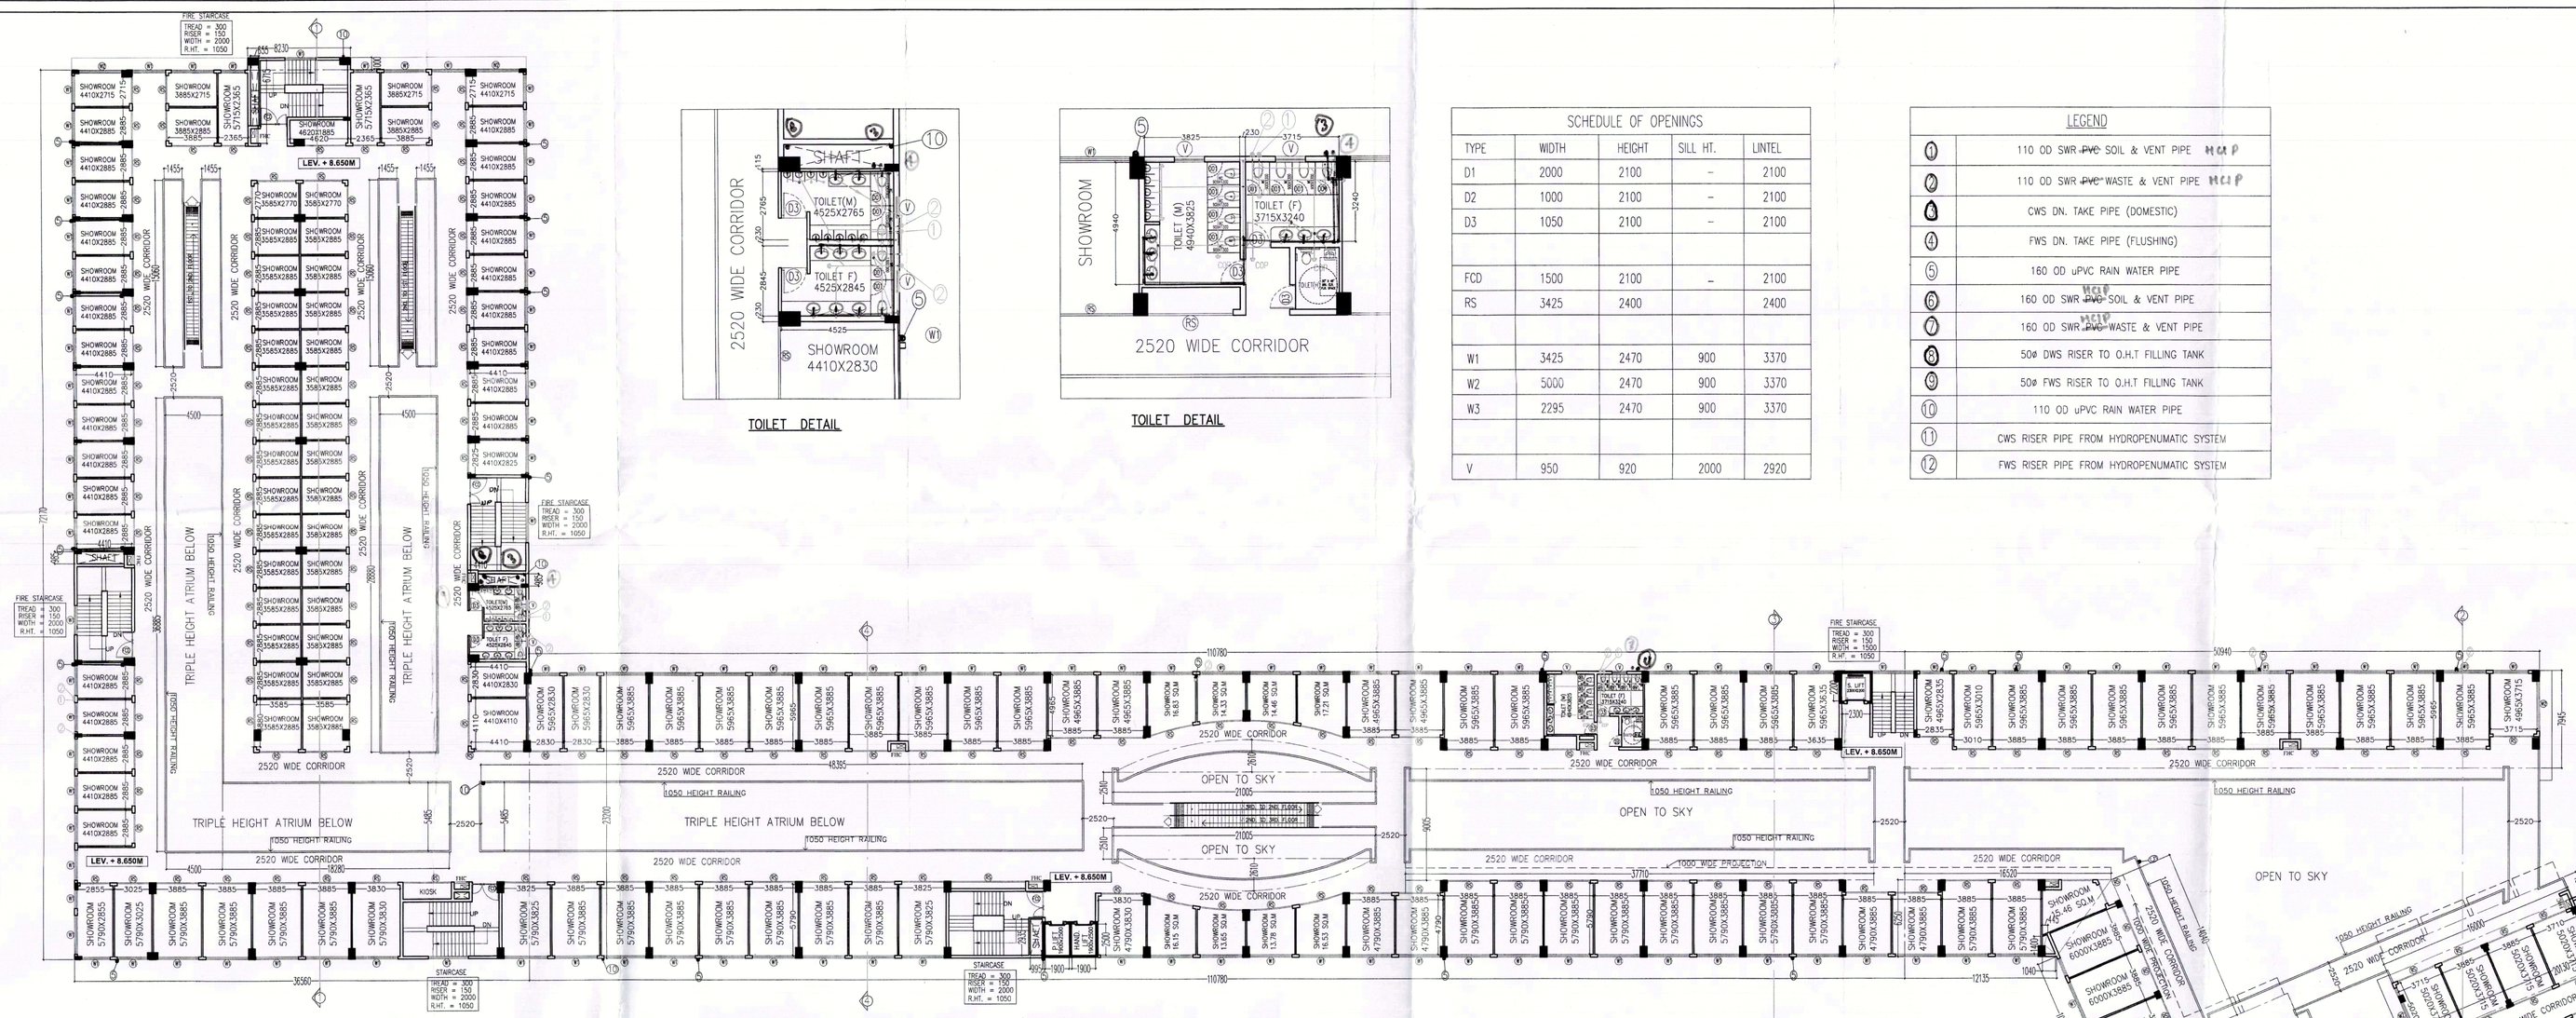

SECOND FLOOR PLAN

TOILET DETAIL

TOILET DETAIL

SCHEDULE OF OPENINGS				
TYPE	WIDTH	HEIGHT	SILL HT.	LINTEL
D1	2000	2100	–	2100
D2	1000	2100	–	2100
D3	1050	2100	–	2100
FCD	1500	2100	–	2100
RS	3425	2400		2400
W1	3425	2470	900	3370
W2	5000	2470	900	3370
W3	2295	2470	900	3370
V	950	920	2000	2920

LEGEND	
1	110 OD SWR ~~PVC~~ MCLP SOIL & VENT PIPE
2	110 OD SWR ~~PVC~~ MCLP WASTE & VENT PIPE
3	CWS DN. TAKE PIPE (DOMESTIC)
4	FWS DN. TAKE PIPE (FLUSHING)
5	160 OD uPVC RAIN WATER PIPE
6	160 OD SWR ~~PVC~~ MCLP SOIL & VENT PIPE
7	160 OD SWR ~~PVC~~ MCLP WASTE & VENT PIPE
8	50ø DWS RISER TO O.H.T FILLING TANK
9	50ø FWS RISER TO O.H.T FILLING TANK
10	110 OD uPVC RAIN WATER PIPE
11	CWS RISER PIPE FROM HYDROPENUMATIC SYSTEM
12	FWS RISER PIPE FROM HYDROPENUMATIC SYSTEM

D.T.P. (HQ) Member Secretary B.P.C. — S.T.P. (G) Member B.P.C. — Chairman B.P.C.

AD — PA — ATP

Checked and found ok for Public Health (Internal) Service only subject to comments in forwarding letter No. 5755/PH ... Dt. 28.08.16

47359

(RAM AVTAR BASSI) A.D. — (BALWANT SINGH) SDO(Q)

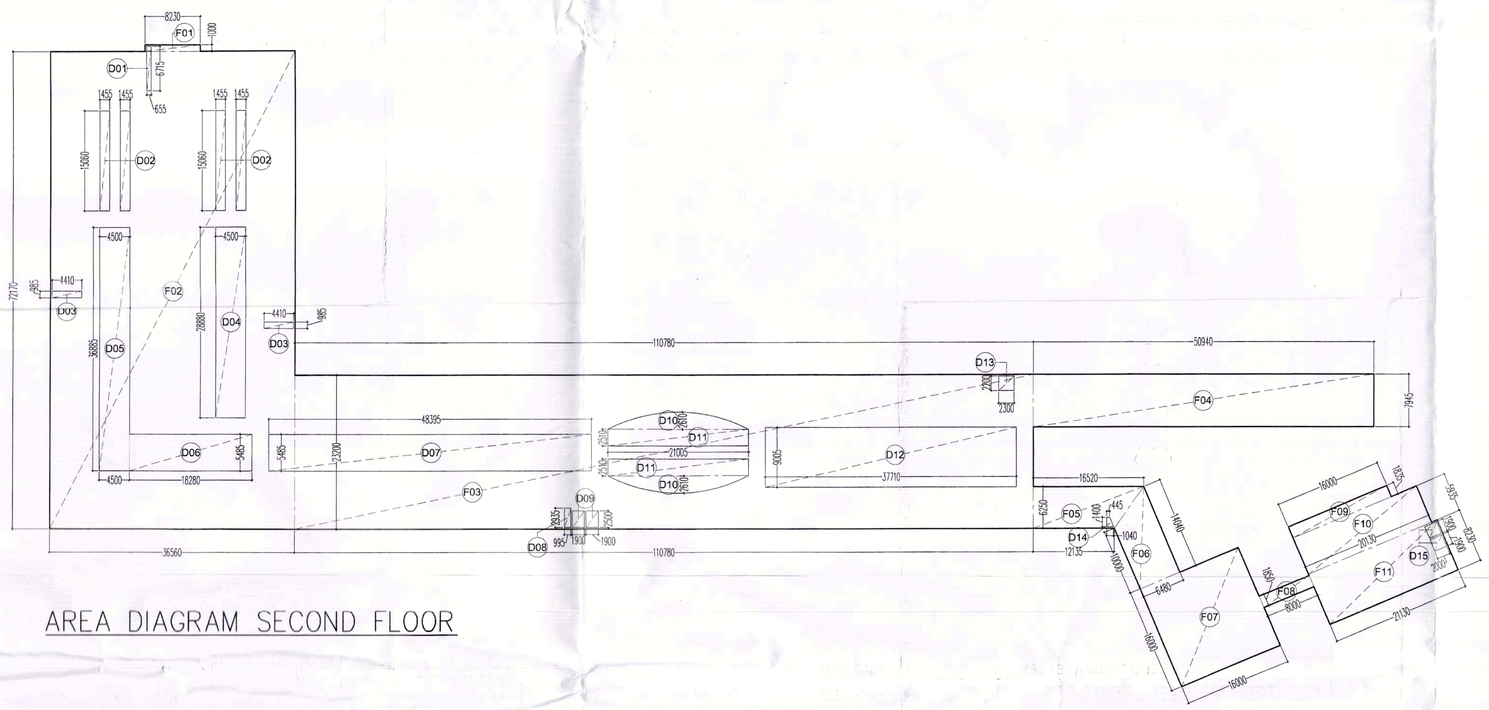

AREA DIAGRAM SECOND FLOOR

SECOND FLOOR AREA CALCULATION						
TOTAL SECOND FLOOR FAR AREA = ADDITION AREA - DEDUCTION AREA						
ADDITION AREA						
Sr No	Dim (m)	X	Dim (m)	Fec.	Nos	Area (SQM)
F1	8.230	X	1.000	1.00	1	8.230
F2	36.560	X	72.170	1.00	1	2638.535
F3	110.780	X	23.200	1.00	1	2570.096
F4	50.940	X	7.945	1.00	1	404.718
F5	(16.520 + 12.135) / 2 X 6.250				1	89.546
F6	(10.000 + 14.040) / 2 X 6.480				1	77.889
F7	16.000	X	16.000	1.00	1	256.000
F8	8.000	X	1.850	1.00	1	14.800
F9	16.000	X	1.835	1.00	1	29.360
F10	20.130	X	5.935	1.00	1	119.472
F11	21.130	X	8.230	1.00	1	173.900
TOTAL ADDITION AREA (A)						6382.546
DEDUCTION AREA						
D1	0.655	X	6.715	1.00	1	4.398
D2	1.455	X	15.060	1.00	4	87.649
D3	4.410	X	0.985	1.00	2	8.688
D4	4.500	X	28.880	1.00	1	129.960
D5	4.500	X	36.885	1.00	1	165.983
D6	18.280	X	5.485	1.00	1	100.266
D7	48.395	X	5.485	1.00	1	265.447
D8	0.995	X	2.935	1.00	1	2.920
D9	1.900	X	2.500	1.00	2	9.500
D10	2.610	X	21.005	0.67	2	73.463
D11	21.005	X	2.510	1.00	2	105.445
D12	37.710	X	9.005	1.00	1	339.579
D13	2.300	X	2.200	1.00	1	5.060
D14	(1.040 + 0.445) / 2 X 1.400				1	1.039
D15	2.000	X	1.900	1.00	2	7.600
TOTAL DEDUCTION AREA (B)						1306.996
TOTAL FAR AREA SECOND FLOOR (C)= (A-B)						5075.550

For MANISH BUILDWELL PVT. LTD.

Director

OWNER'S SIGN

GIAN P. MATHUR ARCHITECT B.ARCH. M.C.A. A.I.I.P. C.A No. 805769

ARCHITECT'S SIGN

PROJECT:

REVISED BUILDING PLAN OF COMMERCIAL COLONY FOR THE AREA MEASURING 3.725 ACRES (LICENCE NO.28 DATED 24.06.2009) IN THE REVENUE ESTATE OF VILLAGE–MEWKA, SECTOR 91 , GURGAON
BEING DEVELOPED BY M/S MANISH BUILDWELL PVT.LTD

UNIT:

TITLE: SECOND FLOOR PLAN

THIS DRAWING IS THE PROPERTY OF GIAN.P.MATHUR & ASSO.(P) LTD AND SHALL NOT BE USED,COPIED OR REPRODUCED WITHOUT THIER WRITTEN PERMISSION

GIAN P. MATHUR AND ASSOCIATES (P) LTD.
C - 55, East Of Kailash, New Delhi-110065
T : 46599591 F 46599512
E : info@gpmindia.com I W : www.gpmindia.com

DEALT	YUNUSH
CHKD	BIPIN

SCALE 1:200 DRG.NO. SB-06/10